


# RECORD DRA WING, ROADS AND DRAINAGE

## COLLEGE OF COASTAL GEORGIA NEW RESIDENCE HALLS

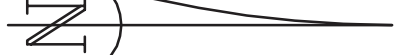

TO THE BEST OF MY KNOWLEDGE, INFORMATION AND BELIEF, THIS DRAWING ACCURATELY REPRESENTS THE TRUE CONDITIONS IN THE FIELD.

LONG ENGINEERING

I CERTIFY THAT TO THE BEST OF MY KNOWLEDGE AND BELIEF THE STORM DRAIN SYSTEM RECORD DRAWINGS SHOWN HEREON ARE AN ACCURATE REPRESENTATION OF FIELD CONDITIONS. STORM DRAIN LINE LOCATIONS ARE BASED UPON AERIAL PHOTOGRAPHY, FIELD SURVEY DATA, AND EXISTING (MANHOLES, PIPES AND CATCH BASINS).

C. TEEPLE HILL, GA. RLS# 3091

I CERTIFY THAT ALL CONSTRUCTION MEETS H.J. RUSSELL CONSTRUCTION COMPANY STANDARDS AND CURRENT CLNN COUNTY SPECIFICATIONS.



H.J. RUSSELL & COMPANY

### NOTES:

- HORIZONTAL DATUM IS BASED ON GEORGIA STATE PLANE EAST ZONE NAD-83 COORDINATE SYSTEM AND WAS ESTABLISHED BY RTK-GPS TECHNOLOGY USING A TRIMBLE 5600 RECEIVER AND GPS SOLUTIONS.
- VERTICAL DATUM IS BASED IN MVD-88 AND WAS ESTABLISHED BY RTK-GPS TECHNOLOGY USING A TRIMBLE 5600 RECEIVER AND GPS SOLUTIONS.
- WATER AND FORCE MAIN LOCATIONS TAKEN FROM CONTRACTOR MARKUPS AND FIELD LOCATIONS OF ABOVE GROUND READABLY VISIBLE STRUCTURES: SANITARY SEWER, GRAVITY LINES, STORM DRAINAGE, AND ROADS TAKEN FROM FIELD LOCATIONS.
- BUILDINGS AND SIDEWALKS WERE TAKEN FROM CONSTRUCTION PLANS AND ARE FOR ILLUSTRATION PURPOSES ONLY.
- THE PARCEL IDENTIFICATION NUMBER FOR THIS TRACT IS 01-08131.
- CONTRACTOR: J. HERS COMPANY, INC.  
1825 W. BAYVIEW DRIVE  
BAXLEY, GEORGIA 3  
(912) 367-7861

### LEGEND:

- ASPHALT
- CONCRETE

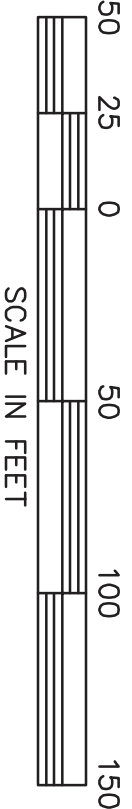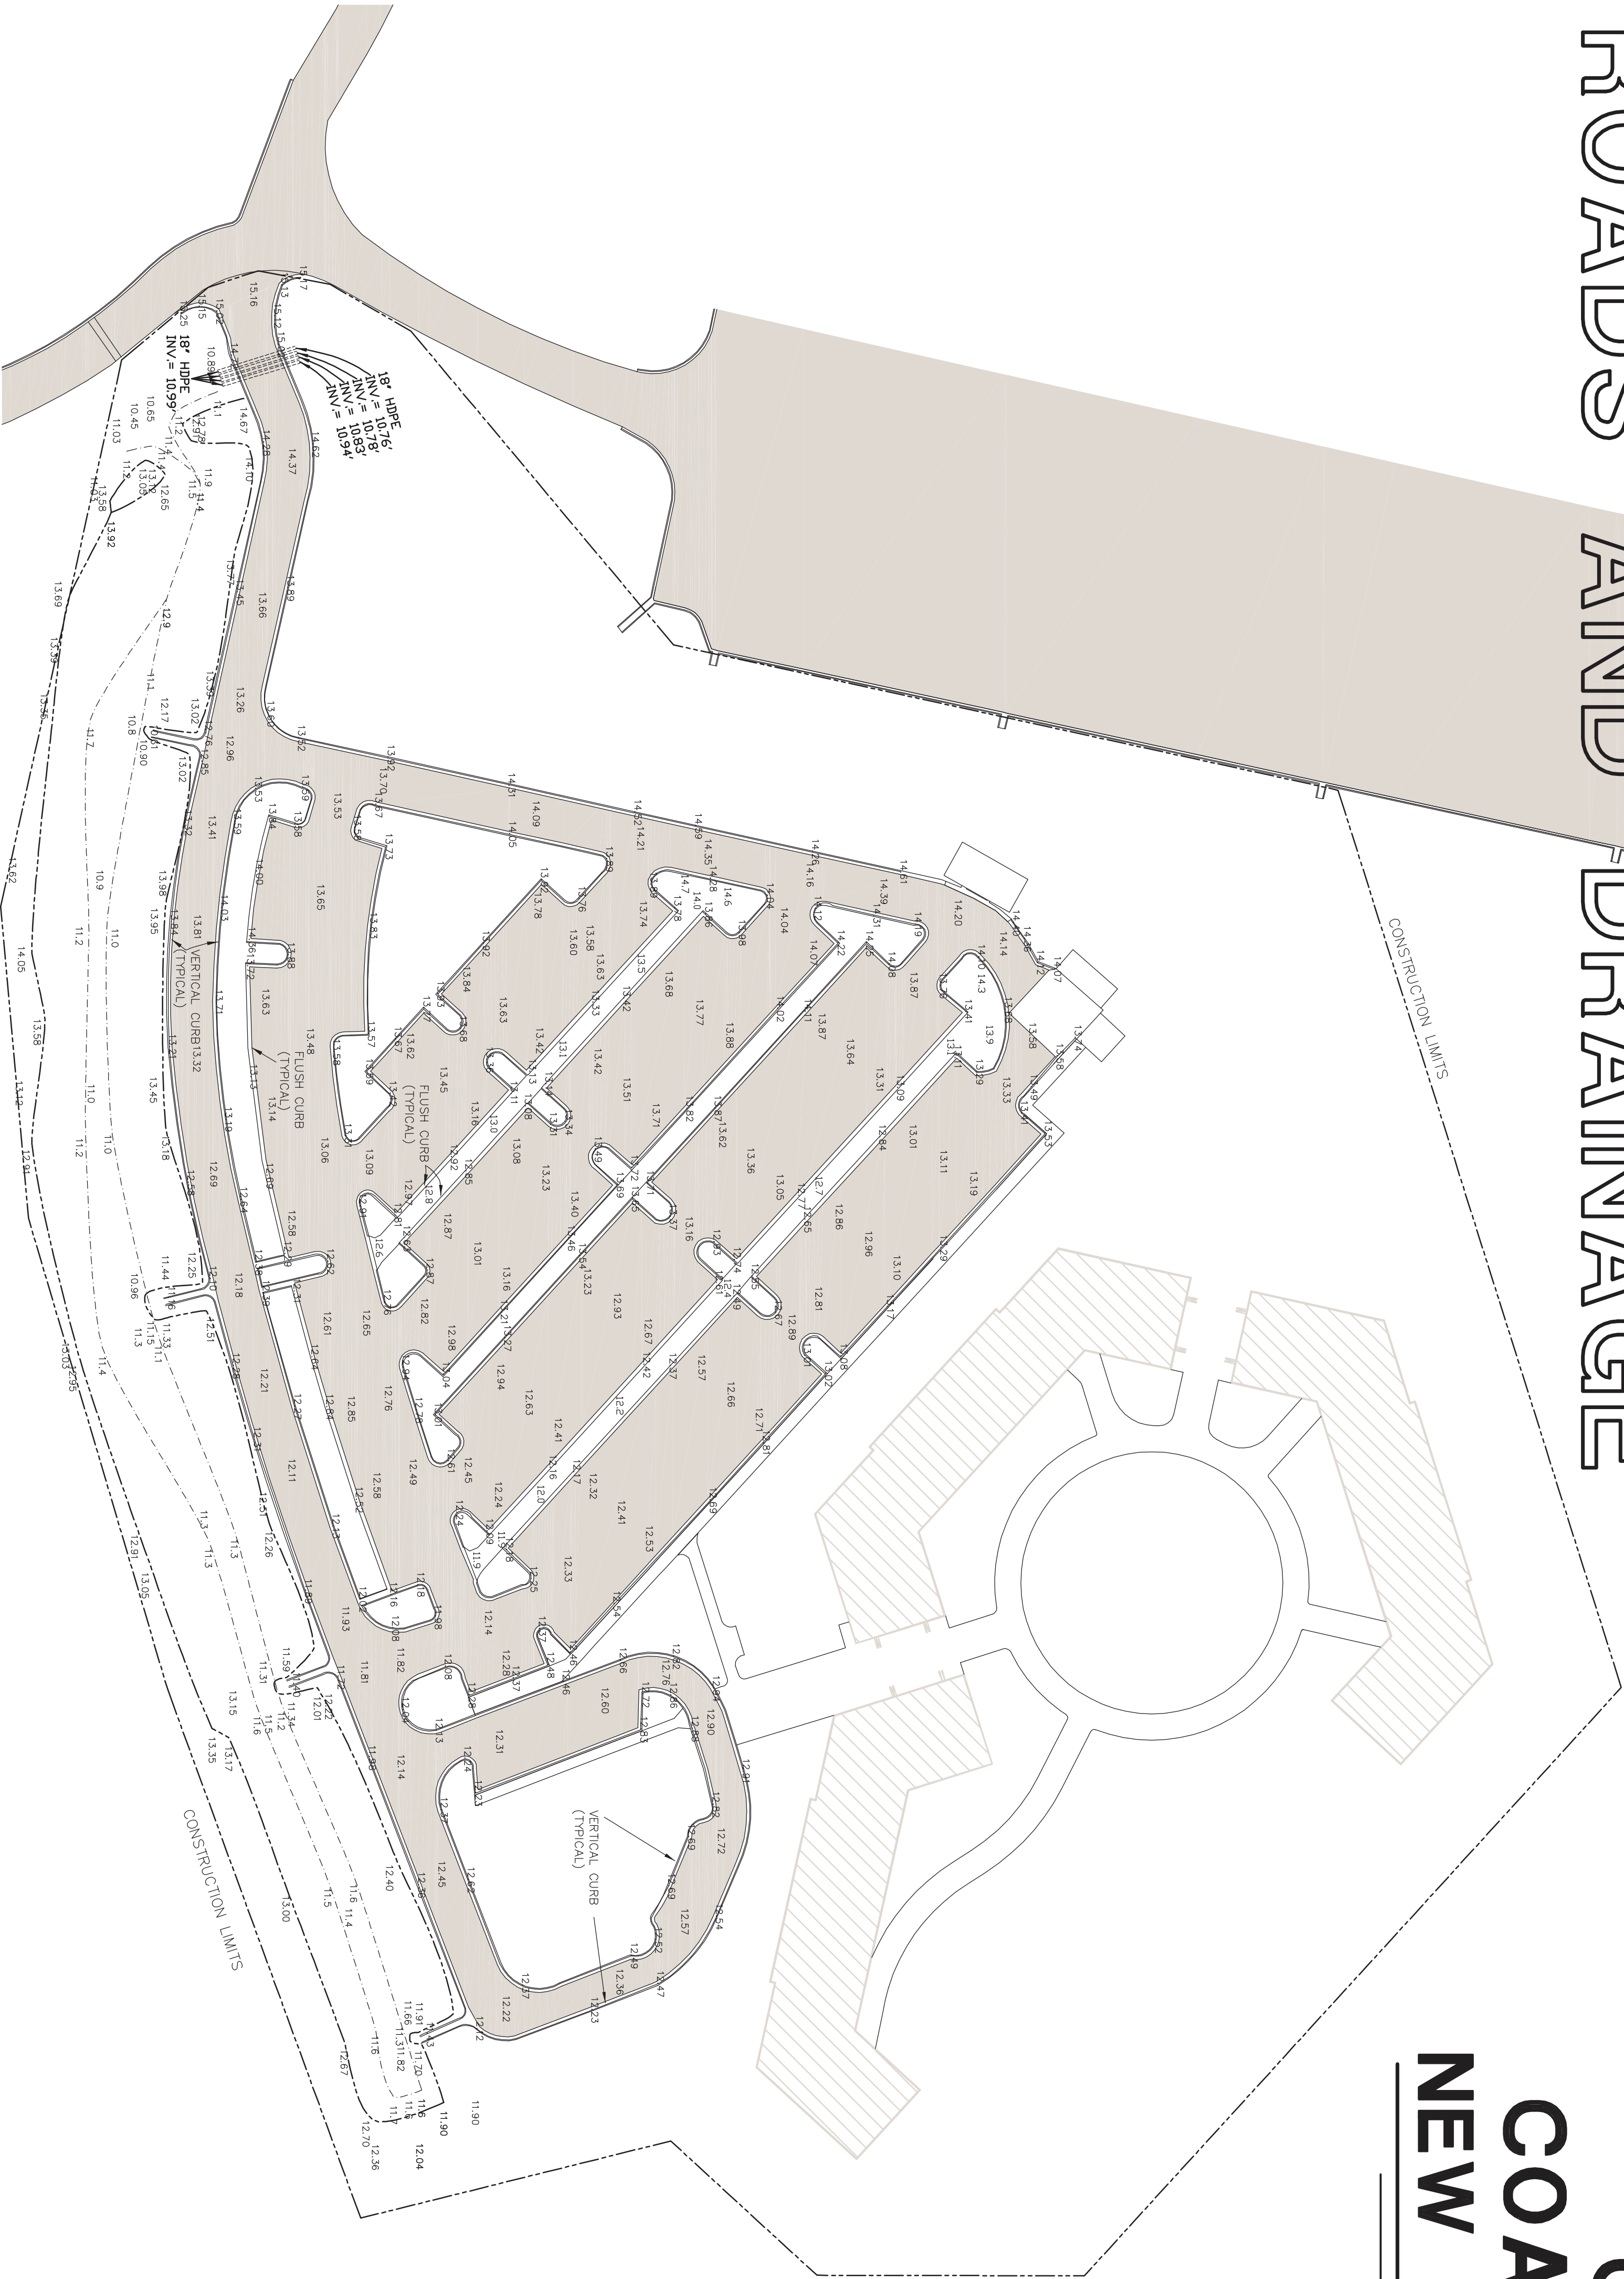

### SURVEY FOR: H.J. RUSSELL & COMPANY

RECORD DRAWINGS OF: COGA NEW RESIDENCE HALLS

G.M.D. 26, CITY OF BRUNSWICK, CLYNN COUNTY, GEORGIA	
DATE: 4/27/11	DRAWN BY: RNS JR.
EQUIPMENT USED: FIELD CLOSURE: TOPCON DTS 303	SCALE: 1"= 50'
	PLAT CLOSURE: N/A
	JOB # 10121



SHUPE SURVEYING COMPANY, P.C.  
3637 DARIEN HWY.  
BRUNSWICK, GEORGIA 31525  
912-285-0862

10121-1.DWG

THIS DOCUMENT ORIGINALLY DESIGNED AND  
DRAWN BY: RNS JR. (RNS) AND  
CHECKED BY: RNS JR. (RNS) IS  
CONSIDERED A CERTIFIED DOCUMENT.